

Subject: FW: NEW (4-Series) - Kenilworth Elementary (Redditt/Tully) DUE = Next Available  
From: Jill Hundley <jhundley@vollrathco.com>  
Date: 8/22/2022, 10:27 AM  
To: "ddb@dauidbethel.com" <ddb@dauidbethel.com>

Good Morning David- Here is another project for you!  
Thanks,  
Jill

## Jill Hundley

Industrial Design Manager, THE VOLLRATH CO., LLC  
1236 N. 18th Street, Sheboygan, WI 53081  
O: 920.459.5302 EXT.: 5302  
[jhundley@vollrathco.com](mailto:jhundley@vollrathco.com) | [vollrathcompany.com](http://vollrathcompany.com)


---

From: Sheila Oppeneer <sheila.openeer@vollrathco.com>  
Sent: Monday, August 15, 2022 11:39 AM  
To: presaledesign <presaledesign@vollrathco.com>  
Cc: James Edson <james.edson@vollrathco.com>; Anthony Bruni  
<anthony.bruni@vollrathco.com>; Michael Komendat <mkomendat@vollrathco.com>; Jill  
Hundley <jhundley@vollrathco.com>; Carey Klug <carey.klug@vollrathco.com>  
Subject: NEW (4-Series) - Kenilworth Elementary (Redditt/Tully) DUE = Next Available

Hello,  
Sales is requesting drawings for Kenilworth Elementary School.

I have attached –

1. Quote
2. Item #4 has a Two Tiered Over Shelf Speed Serve Style Unit with LED Light Strip on Top Level – this is the same as was done for Kiva Elementary, drawn by Erin.

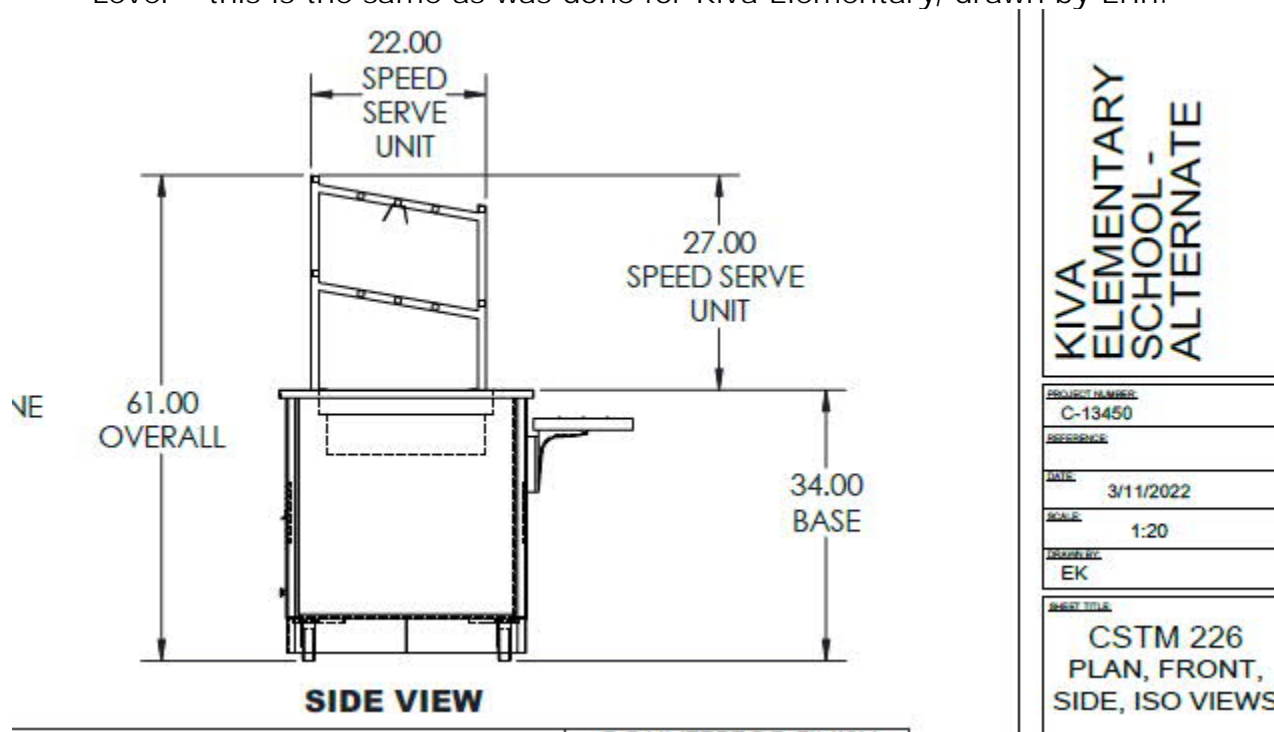

I would strongly suggest the drawing for this project is in house and not send to David Bethel.

REQUESTED DELIVERABLE = Drawing Packet

Please let me know if you have any questions.

Thank you,  
Sheila

**Sheila Oppeneer**

Project Developer

THE VOLLRATH CO., LLC

1236 N. 18th Street, Sheboygan, WI 53081

O: 920.459.5222

[sheila.openeer@vollrathco.com](mailto:sheila.openeer@vollrathco.com) | [vollrathcompany.com](http://vollrathcompany.com)

— Attachments: —

---

Quote\_Kenilworth\_Elem\_School\_C\_13838.pdf

209 KB

Subject: RE: KENILWORTH ES - VL-KENIL # 1

From: Sheila Oppeneer <sheila.openeer@vollrathco.com>


Date: 8/26/2022, 3:02 PM

To: David Bethel <ddb@davidbethel.com>, Jill Hundley <jhundley@vollrathco.com>

Hi David,

Please update item #4 – storage is listed on the quote. Please remove the note about the 'Powder Coat TBD' Storage door.

Also, item #5 from the quote is not found. Please add.

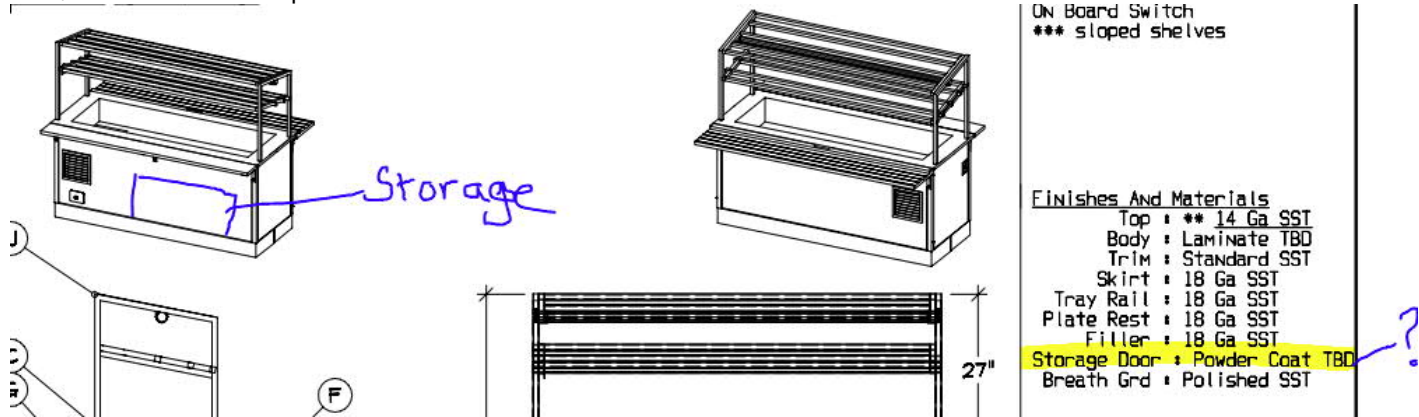

Item	Qty	Description
5	1 ea	<b>4-SERIES, SERVING SYSTEM</b> Vollrath Model No. CUSTOM 28" x 28" x 33" Utility <ul style="list-style-type: none"><li>* Stainless Steel Unibody Construction</li><li>* 4" Swivel Casters (2 Locking)</li><li>* Stainless Steel Skirting</li><li>* Laminated Base (All Exterior Sides) with Stainless Steel Corner Guard &amp; Trim Strips</li><li>* Open Storage (Bag In Box Style/Open with Floor)</li><li>* 14 Gauge Stainless Steel Countertop</li><li>* 18 Gauge Stainless Steel Plate Rest (OPERATOR SIDE)</li><li>* 18 Gauge Stainless Steel V Rib Tray Slide (CUSTOMER SIDE)</li><li>* No Equipment Installed in Countertop</li><li>* Contemporary Breath Guard - NSF Cafeteria</li><li>* Lighting in Breath Guard</li><li>* Single Point Electrical Connection - FINAL PLUG TBD</li><li>* Line Locks</li><li>* Filler Panels</li></ul>

Thanks,  
Sheila

From: David Bethel <ddb@davidbethel.com>

Sent: Friday, August 26, 2022 1:29 PM

To: Jill Hundley <jhundley@vollrathco.com>; Sheila Oppeneer <sheila.openeer@vollrathco.com>

Subject: KENILWORTH ES - VL-KENIL # 1

08-26-2022 : 02:27:25p

--

DIRECT LINK : [HTTP://WWW.DAVIDBETHEL.COM/KENIL/INDEX.HTM](http://www.davidbethel.com/kenil/index.htm)

KENILWORTH ES - JILL HUNDLEY - KENIL

VL-KENIL : KENILWORTH ES

+++++

Thanks! -David

David Bethel

Fabricated Designs, Inc. v. 757-595-5949

<http://www.davidbethel.com> [ddb@davidbethel.com](mailto:ddb@davidbethel.com)

--

This email has been checked for viruses by AVG antivirus software.

[www.avg.com](http://www.avg.com)